

IMPACT PLATE KEYMAP
I-95 ETL NORTHBOUND EXTENSION
PHASE II
MD 24/MD 924 PARK AND RIDE
AS-BUILT
HARFORD COUNTY, MARYLAND



MARYLAND
TRANSPORTATION AUTHORITY

CONTRACT NO. KH-3023

SCALE: 1" = 500'

DATE: DEC. 2022




SCALE: 1" = 500'

Contract KH-3023: MD 24/MD 924 Park & Ride						
Wetland	Plate #	Classification	Wetland Impacts (SF)		Buffer Impacts (SF)	
			Permanent	Temporary	Permanent	Temporary
WET F-3	1	PEM	318	0	0	0
WET F-6	1	PSS	2,114	0	16,012	0
WET F-2	2	PSS	503	0	10,391 10,388	0
WET F-4	2	PFO	892	0		0
WET F-5	2	PFO	755	0		0
Total			4,582	0	26,403	0

Updated Jan 2024

Contract KH-3023: MD 24/MD 924 Park & Ride								
<i>Waterway</i>	<i>Plate #</i>	<i>Classification</i>	<i>Permanent Stream Impacts</i>		<i>Temporary Stream Impacts</i>		<i>Permanent Floodplain Impacts</i>	<i>Temporary Floodplain Impacts</i>
			<i>LF</i>	<i>SF</i>	<i>LF</i>	<i>SF</i>	<i>SF</i>	<i>SF</i>
WUS F-3	1	Intermittent	45	120	0	0	0	0
WUS F-2	1	Intermittent	101	201	0	0	0	0
WUS F-2 (Relocated)	1	Intermittent	46	92	0	0	0	0
WUS F-2 (Relocated)	2	Intermittent	209	397	0	0	0	0
WUS F-1	2	Intermittent	57	120	0	0	0	0
WUS F-1 (Culverted)	2	Intermittent	19	62	0	0	0	0
WUS F-1	2	Perennial	158	840	0	0	0	0
Total			635	1832	0	0	0	0

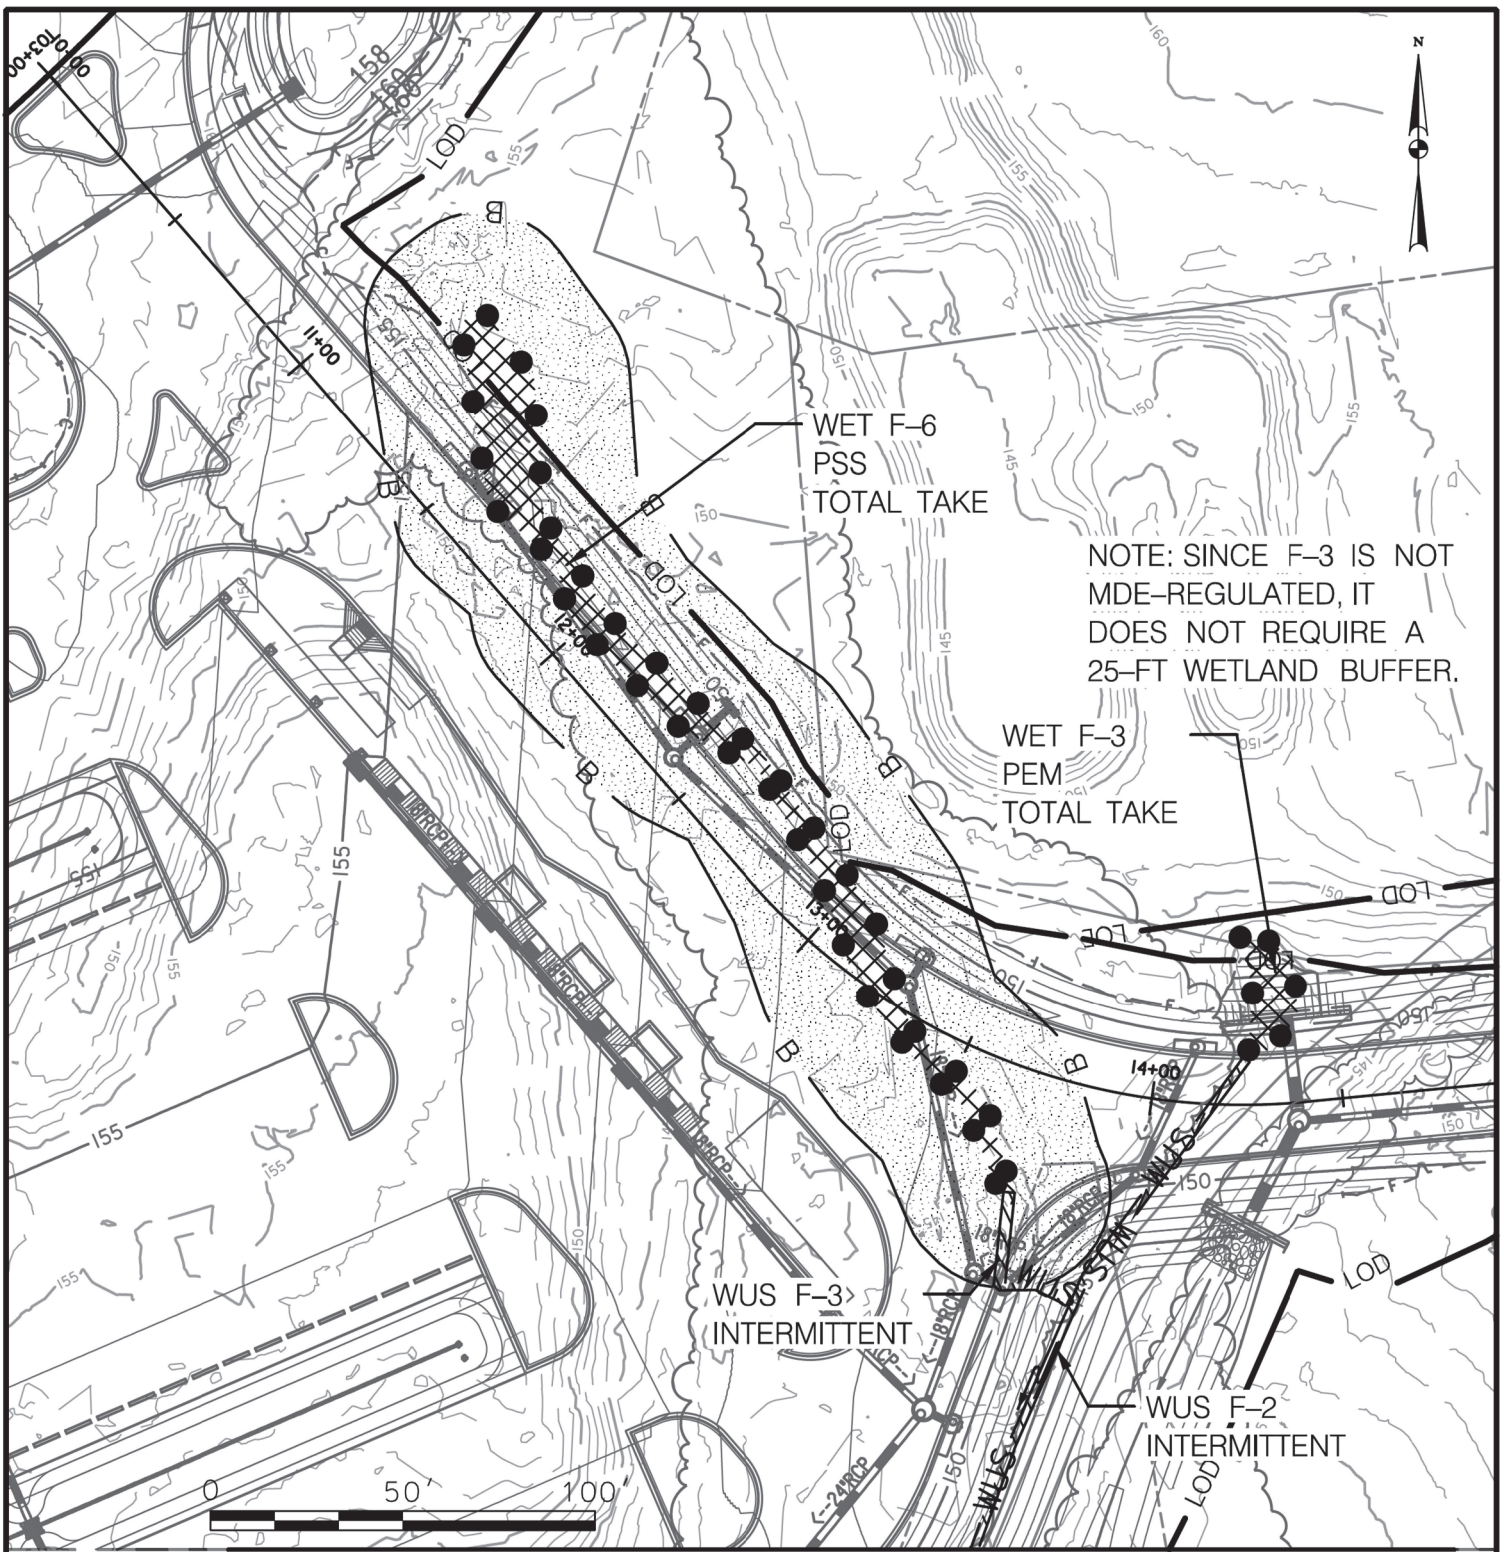

NOTE: SINCE F-3 IS NOT MDE-REGULATED, IT DOES NOT REQUIRE A 25-FT WETLAND BUFFER.

MATCHLINE PLATE 2

IMPACTS ON THIS PLATE

	TEMPORARY	PERMANENT
PFO WETLAND	0 SF	0 SF
PSS WETLAND	0 SF	2,114 SF
PEM WETLAND	0 SF	318 SF
PERENNIAL WUS	0 SF/LF	0 SF/LF
INTERMITTENT WUS	0 SF/LF	413/192 SF/LF
EPHEMERAL WUS	0 SF/LF	0 SF/LF
WETLAND BUFFER	0 SF	16,012 SF
100-YEAR FLOODPLAIN	0 SF	0 SF

WETLAND IMPACT PLATE

I-95 ETL NORTHBOUND EXTENSION
 PHASE II
 MD 24/MD 924 PARK AND RIDE
 AS-BUILT
 HARFORD COUNTY, MARYLAND




**MARYLAND
 TRANSPORTATION AUTHORITY**

SCALE: 1" = 50'

CONTRACT NO.: KH-3023

DATE: DEC. 2022

PLATE 1 OF 2

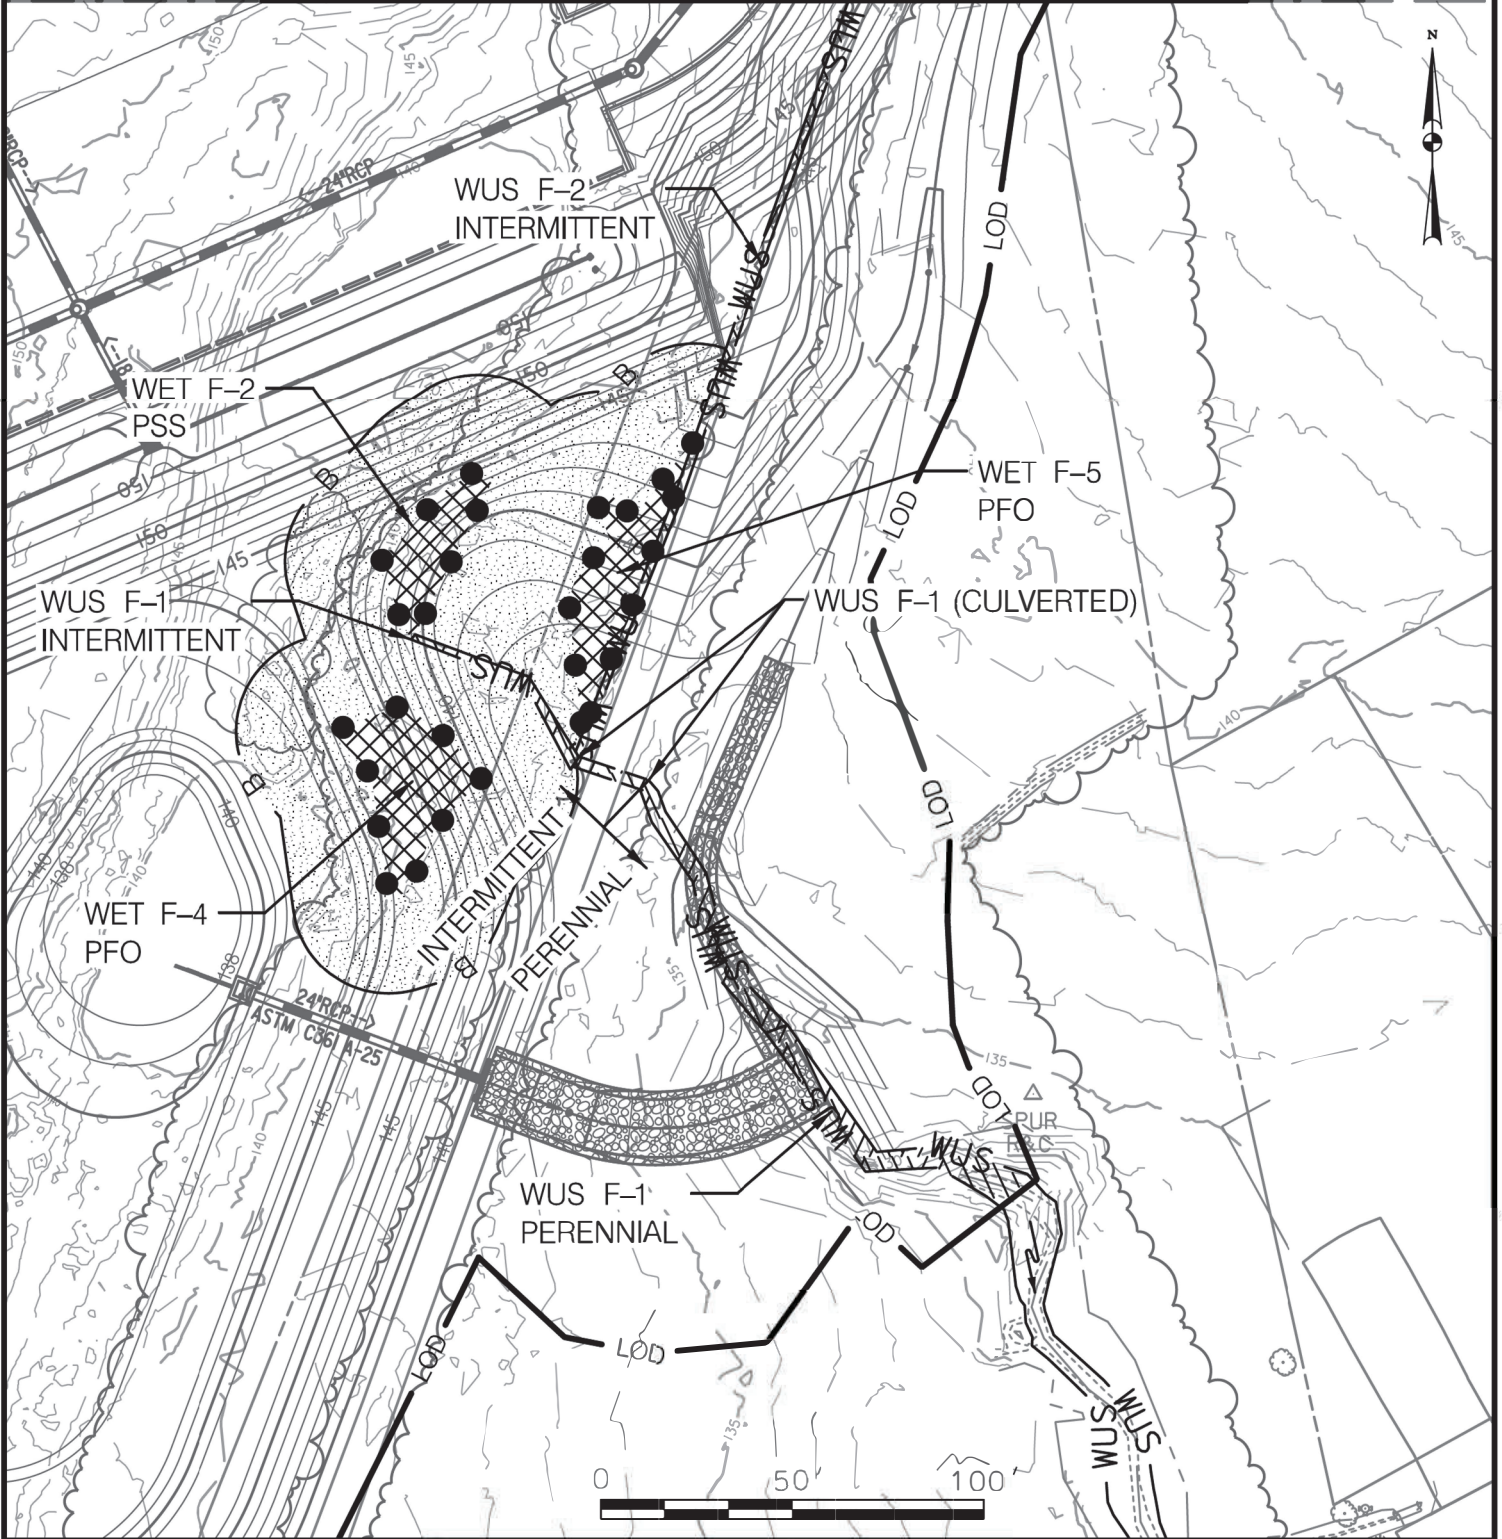

IMPACTS ON THIS PLATE

	TEMPORARY	PERMANENT
PFO WETLAND	0 SF	1,647 SF
PSS WETLAND	0 SF	503 SF
PEM WETLAND	0 SF	0 SF
PERENNIAL WUS	0 SF/LF	840/158 SF/LF
INTERMITTENT WUS	0 SF/LF	579/285 SF/LF
EPHEMERAL WUS	0 SF/LF	0 SF/LF
WETLAND BUFFER	0 SF	10,388 10,391 SF
100-YEAR FLOODPLAIN	0 SF	0 SF

WETLAND IMPACT PLATE

I-95 ETL NORTHBOUND EXTENSION
 PHASE II
 MD 24/MD 924 PARK AND RIDE
 AS-BUILT
 HARFORD COUNTY, MARYLAND



**MARYLAND
 TRANSPORTATION AUTHORITY**

SCALE: 1" = 50'

CONTRACT NO.: KH-3023

DATE: DEC. 2022 ^{Updated Jan 2024}

PLATE 2 OF 2